

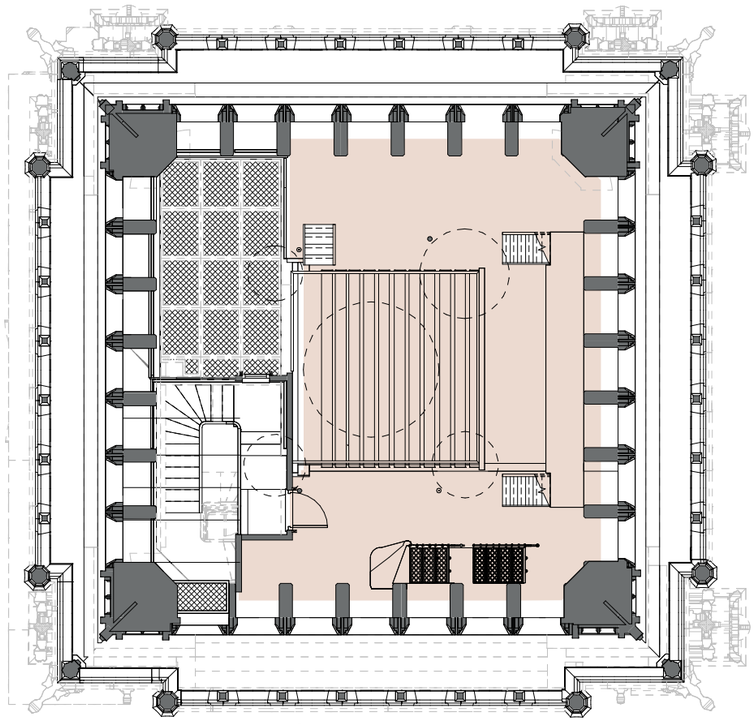



2 CTA-1 **Belfry Plan as Existing**
1 : 50

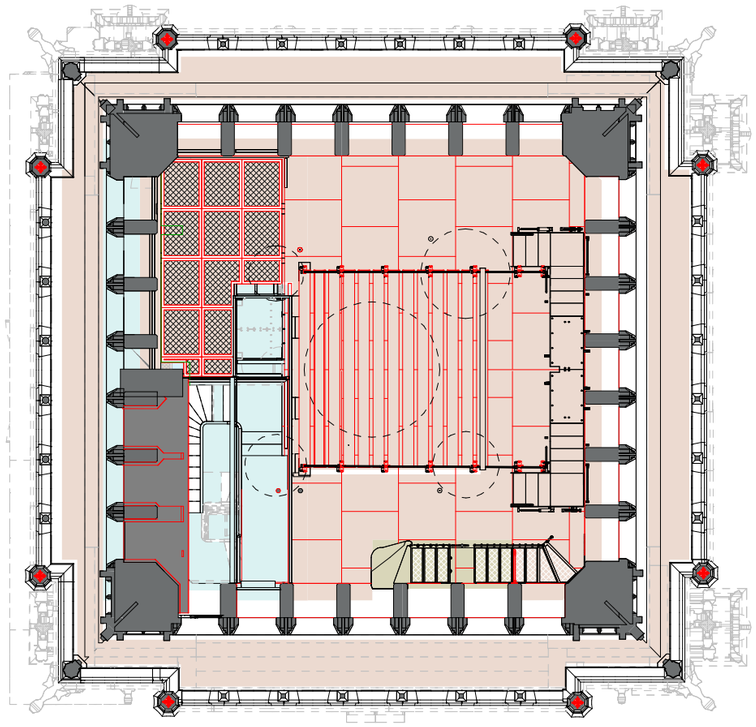

4 CTA-1 **Belfry Plan as Constructed**
1 : 50

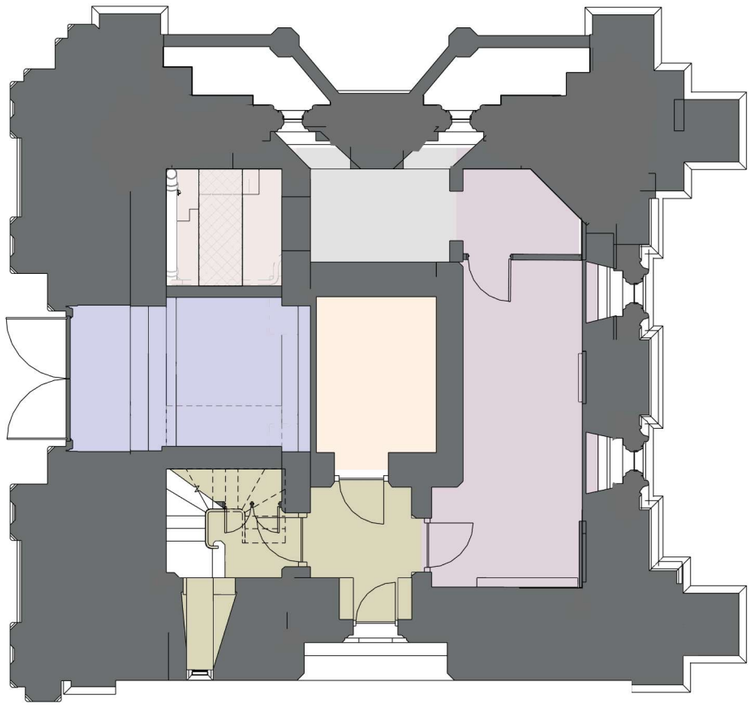

1 CTA-1 **Ground Floor as Existing**
1 : 50

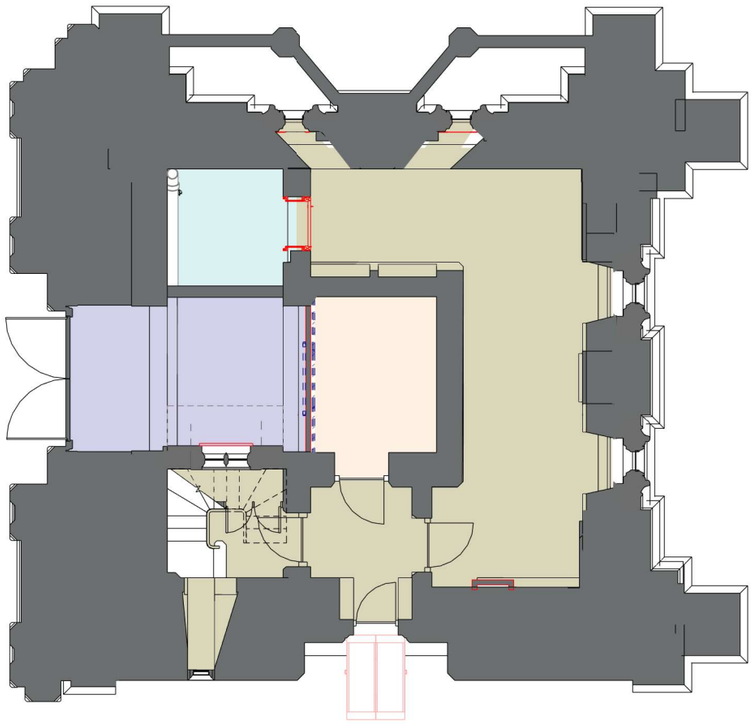

3 CTA-1 **Ground Floor as Constructed**
1 : 50