


1 **Section as Existing**
CTA-2 1 : 100

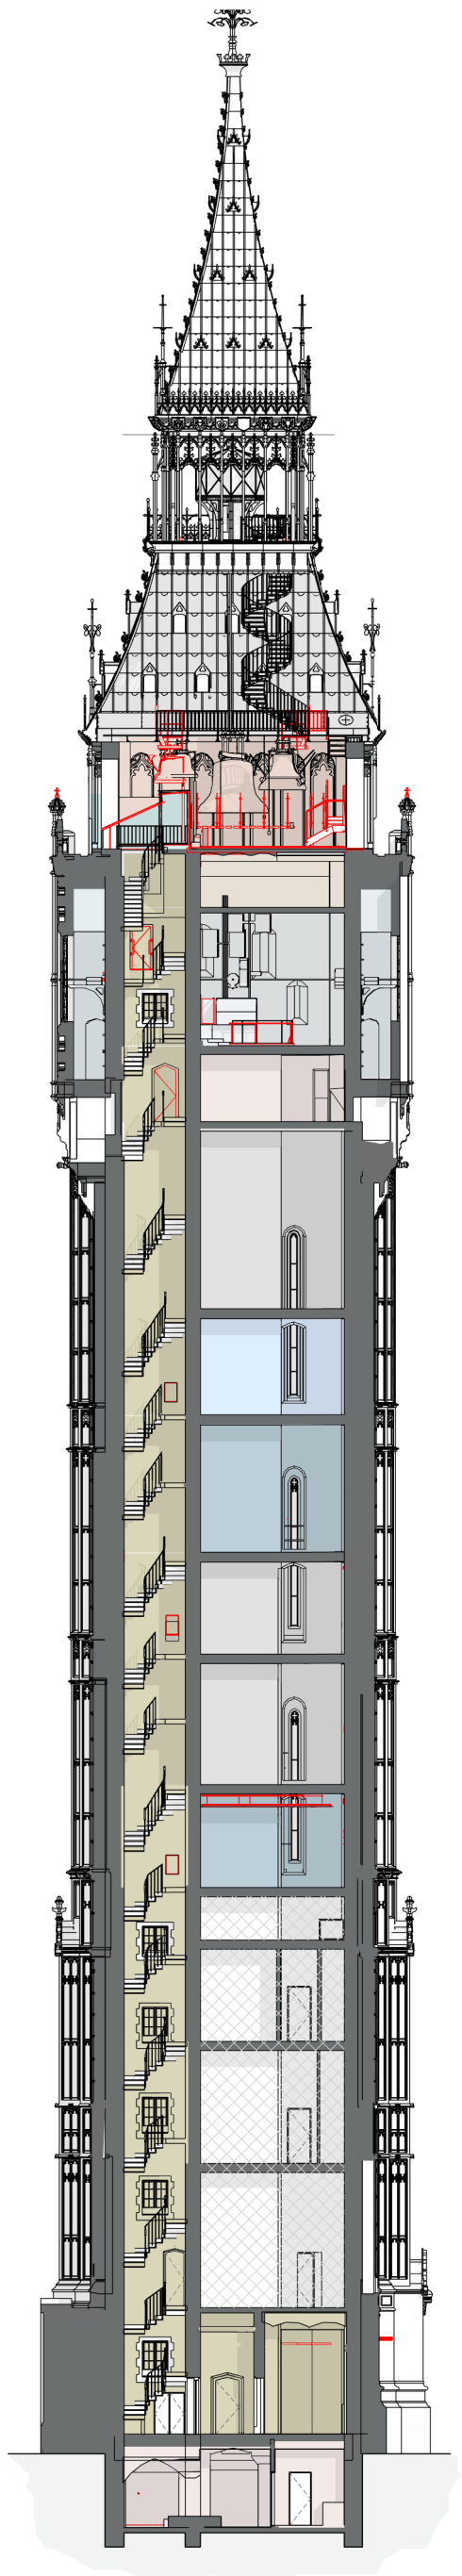

2 **Section as Proposed**
CTA-2 1 : 100